

ELEVATION CERTIFICATE

OMB No. 1660-0008
Expires March 31, 2012

Important: Read the instructions on pages 1-9.

SECTION A - PROPERTY INFORMATION

A1. Building Owner's Name <u>John Robertson and Melanie Robertson</u>		For Insurance Company Use:
A2. Building Street Address (including Apt., Unit, Suite, and/or Bldg. No.) or P.O. Route and Box No. <u>477 20th Avenue</u>		Policy Number
City <u>Indian Rocks Beach</u> State <u>FL</u> ZIP Code <u>33785</u>		Company NAIC Number
A3. Property Description (Lot and Block Numbers, Tax Parcel Number, Legal Description, etc.) <u>W. 1/2 of Lot 63 & all of Lot 64, Fifteenth Addition to Re-Revised Map of Indian Beach</u>		
A4. Building Use (e.g., Residential, Non-Residential, Addition, Accessory, etc.) <u>Residential</u>		
A5. Latitude/Longitude: Lat. <u>27d 54' 06.24" N</u> Long. <u>82d 50' 21.59" W</u>		Horizontal Datum: <input type="checkbox"/> NAD 1927 <input checked="" type="checkbox"/> NAD 1983
A6. Attach at least 2 photographs of the building if the Certificate is being used to obtain flood insurance.		
A7. Building Diagram Number <u>1A</u>		
A8. For a building with a crawlspace or enclosure(s):		A9. For a building with an attached garage:
a) Square footage of crawlspace or enclosure(s) <u>NA</u> sq ft		a) Square footage of attached garage <u>482.4</u> sq ft
b) No. of permanent flood openings in the crawlspace or enclosure(s) within 1.0 foot above adjacent grade <u>NA</u>		b) No. of permanent flood openings in the attached garage within 1.0 foot above adjacent grade <u>NA</u>
c) Total net area of flood openings in A8.b <u>NA</u> sq in		c) Total net area of flood openings in A9.b <u>NA</u> sq in
d) Engineered flood openings? <input type="checkbox"/> Yes <input checked="" type="checkbox"/> No		d) Engineered flood openings? <input type="checkbox"/> Yes <input checked="" type="checkbox"/> No

SECTION B - FLOOD INSURANCE RATE MAP (FIRM) INFORMATION

B1. NFIP Community Name & Community Number <u>Indian Rocks Beach 125117</u>		B2. County Name <u>Pinellas</u>		B3. State <u>Florida</u>	
B4. Map/Panel Number <u>12103C 0114</u>	B5. Suffix <u>G</u>	B6. FIRM Index Date <u>9/3/03</u>	B7. FIRM Panel Effective/Revised Date <u>9/3/03</u>	B8. Flood Zone(s) <u>AE</u>	B9. Base Flood Elevation(s) (Zone AO, use base flood depth) <u>10.0'</u>
B10. Indicate the source of the Base Flood Elevation (BFE) data or base flood depth entered in Item B9. <input type="checkbox"/> FIS Profile <input checked="" type="checkbox"/> FIRM <input type="checkbox"/> Community Determined <input type="checkbox"/> Other (Describe) _____					
B11. Indicate elevation datum used for BFE in Item B9: <input type="checkbox"/> NGVD 1929 <input checked="" type="checkbox"/> NAVD 1988 <input type="checkbox"/> Other (Describe) _____					
B12. Is the building located in a Coastal Barrier Resources System (CBRS) area or Otherwise Protected Area (OPA)? Designation Date _____ <input type="checkbox"/> CBRS <input type="checkbox"/> OPA <input type="checkbox"/> Yes <input checked="" type="checkbox"/> No					

SECTION C - BUILDING ELEVATION INFORMATION (SURVEY REQUIRED)

C1. Building elevations are based on: Construction Drawings* Building Under Construction* Finished Construction
*A new Elevation Certificate will be required when construction of the building is complete.


C2. Elevations - Zones A1-A30, AE, AH, A (with BFE), VE, V1-V30, V (with BFE), AR, AR/A, AR/AE, AR/A1-A30, AR/AH, AR/AO. Complete Items C2.a-h below according to the building diagram specified in Item A7. Use the same datum as the BFE.
Benchmark Utilized Hall H Vertical Datum NAVD 1988
Conversion/Comments _____


Check the measurement used.

a) Top of bottom floor (including basement, crawlspace, or enclosure floor) <u>5.5</u>	<input checked="" type="checkbox"/> feet <input type="checkbox"/> meters (Puerto Rico only)
b) Top of the next higher floor <u>NA</u>	<input checked="" type="checkbox"/> feet <input type="checkbox"/> meters (Puerto Rico only)
c) Bottom of the lowest horizontal structural member (V Zones only) <u>NA</u>	<input checked="" type="checkbox"/> feet <input type="checkbox"/> meters (Puerto Rico only)
d) Attached garage (top of slab) <u>4.8</u>	<input checked="" type="checkbox"/> feet <input type="checkbox"/> meters (Puerto Rico only)
e) Lowest elevation of machinery or equipment servicing the building (Describe type of equipment and location in Comments) <u>4.8</u>	<input checked="" type="checkbox"/> feet <input type="checkbox"/> meters (Puerto Rico only)
f) Lowest adjacent (finished) grade next to building (LAG) <u>4.5</u>	<input checked="" type="checkbox"/> feet <input type="checkbox"/> meters (Puerto Rico only)
g) Highest adjacent (finished) grade next to building (HAG) <u>4.7</u>	<input checked="" type="checkbox"/> feet <input type="checkbox"/> meters (Puerto Rico only)
h) Lowest adjacent grade at lowest elevation of deck or stairs, including structural support <u>NA</u>	<input checked="" type="checkbox"/> feet <input type="checkbox"/> meters (Puerto Rico only)

SECTION D - SURVEYOR, ENGINEER, OR ARCHITECT CERTIFICATION

This certification is to be signed and sealed by a land surveyor, engineer, or architect authorized by law to certify elevation information. I certify that the information on this Certificate represents my best efforts to interpret the data available. I understand that any false statement may be punishable by fine or imprisonment under 18 U.S. Code, Section 1001.
Check here if comments are provided on back of form. Were latitude and longitude in Section A provided by a licensed land surveyor? Yes No

Certifier's Name <u>Edward D. Murphy</u>	License Number <u>5333</u>
Title <u>Professional Land Surveyor</u>	Company Name <u>Murphy's Land Surveying, Inc.</u>
Address <u>5760 11th Avenue N.</u>	City <u>St. Petersburg</u> State <u>FL</u> ZIP Code <u>33710</u>
Signature 	Date <u>9/5/12</u> Telephone <u>727/347-8740</u>

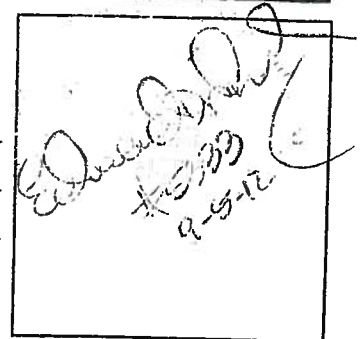

IMPORTANT: In these spaces, copy the corresponding information from Section A.	For Insurance Company Use:
Building Street Address (including Apt., Unit, Suite, and/or Bldg. No.) or P.O. Route and Box No. 477 20 th Avenue	Policy Number
City Indian Rocks Beach State FL ZIP Code 33785	Company NAIC Number

SECTION D - SURVEYOR, ENGINEER, OR ARCHITECT CERTIFICATION (CONTINUED)

Copy both sides of this Elevation Certificate for (1) community official, (2) insurance agent/company, and (3) building owner.

Comments C2e = A/C

Signature Edward D. Friel Date 9/5/12 Check here if attachments

SECTION E - BUILDING ELEVATION INFORMATION (SURVEY NOT REQUIRED) FOR ZONE AO AND ZONE A (WITHOUT BFE)

For Zones AO and A (without BFE), complete items E1-E5. If the Certificate is intended to support a LOMA or LOMR-F request, complete Sections A, B, and C. For Items E1-E4, use natural grade, if available. Check the measurement used. In Puerto Rico only, enter meters.

- E1. Provide elevation information for the following and check the appropriate boxes to show whether the elevation is above or below the highest adjacent grade (HAG) and the lowest adjacent grade (LAG).
 - a) Top of bottom floor (including basement, crawlspace, or enclosure) is _____ feet meters above or below the HAG.
 - b) Top of bottom floor (including basement, crawlspace, or enclosure) is _____ feet meters above or below the LAG.
- E2. For Building Diagrams 6-9 with permanent flood openings provided in Section A Items 8 and/or 9 (see pages 8-9 of Instructions), the next higher floor (elevation C2.b in the diagrams) of the building is _____ feet meters above or below the HAG.
- E3. Attached garage (top of slab) is _____ feet meters above or below the HAG.
- E4. Top of platform of machinery and/or equipment servicing the building is _____ feet meters above or below the HAG.
- E5. Zone AO only: If no flood depth number is available, is the top of the bottom floor elevated in accordance with the community's floodplain management ordinance? Yes No Unknown. The local official must certify this information in Section G.

SECTION F - PROPERTY OWNER (OR OWNER'S REPRESENTATIVE) CERTIFICATION

The property owner or owner's authorized representative who completes Sections A, B, and E for Zone A (without a FEMA-issued or community-issued BFE) or Zone AO must sign here. *The statements in Sections A, B, and E are correct to the best of my knowledge.*

Property Owner's or Owner's Authorized Representative's Name _____

Address _____ City _____ State _____ ZIP Code _____

Signature _____ Date _____ Telephone _____

Comments _____

Check here if attachments

SECTION G - COMMUNITY INFORMATION (OPTIONAL)

The local official who is authorized by law or ordinance to administer the community's floodplain management ordinance can complete Sections A, B, C (or E), and G of this Elevation Certificate. Complete the applicable item(s) and sign below. Check the measurement used in Items G8 and G9.

- G1. The information in Section C was taken from other documentation that has been signed and sealed by a licensed surveyor, engineer, or architect who is authorized by law to certify elevation information. (Indicate the source and date of the elevation data in the Comments area below.)
- G2. A community official completed Section E for a building located in Zone A (without a FEMA-issued or community-issued BFE) or Zone AO.
- G3. The following information (Items G4-G9) is provided for community floodplain management purposes.

G4. Permit Number	G5. Date Permit Issued	G6. Date Certificate Of Compliance/Occupancy Issued
-------------------	------------------------	---

- G7. This permit has been issued for: New Construction Substantial Improvement
- G8. Elevation of as-built lowest floor (including basement) of the building: _____ feet meters (PR) Datum _____
- G9. BFE or (in Zone AO) depth of flooding at the building site: _____ feet meters (PR) Datum _____
- G10. Community's design flood elevation _____ feet meters (PR) Datum _____

Local Official's Name _____ Title _____

Community Name _____ Telephone _____

Signature _____ Date _____

Comments _____

Check here if attachments

Building Photographs

See Instructions for Item A6.

Building Street Address (including Apt., Unit, Suite, and/or Bldg. No.) or P.O. Route and Box No. 477 20 th Avenue	For insurance Company Use: Policy Number
City Indian Rocks Beach State FL ZIP Code 33785	Company NAIC Number
If using the Elevation Certificate to obtain NFIP flood insurance, affix at least two building photographs below according to the instructions for Item A6. Identify all photographs with: date taken; "Front View" and "Rear View"; and, if required, "Right Side View" and "Left Side View." If submitting more photographs than will fit on this page, use the Continuation Page, following.	

DATE: 9/4/12

FRONT VIEW:




REAR VIEW:



CERTIFIED TO: John Robertson and Melanie Robertson
 Integrity Title & Guaranty Agency, LLC / Timothy K. Mariani
 Old Republic National Title Insurance Company

SCALE: 1" = 20' Survey not valid for more than one (1) year from date of field work. SEC. 06 TWP. 30 S. RGE. 15 E.

"The location of the line between flood zones has been approximated based upon flood maps that scale one inch to 500 feet making an exact location of the line impossible to determine. Accordingly, this survey will not be responsible for decisions concerning flood insurance requirements based upon the approximate line of the flood zones shown herein."

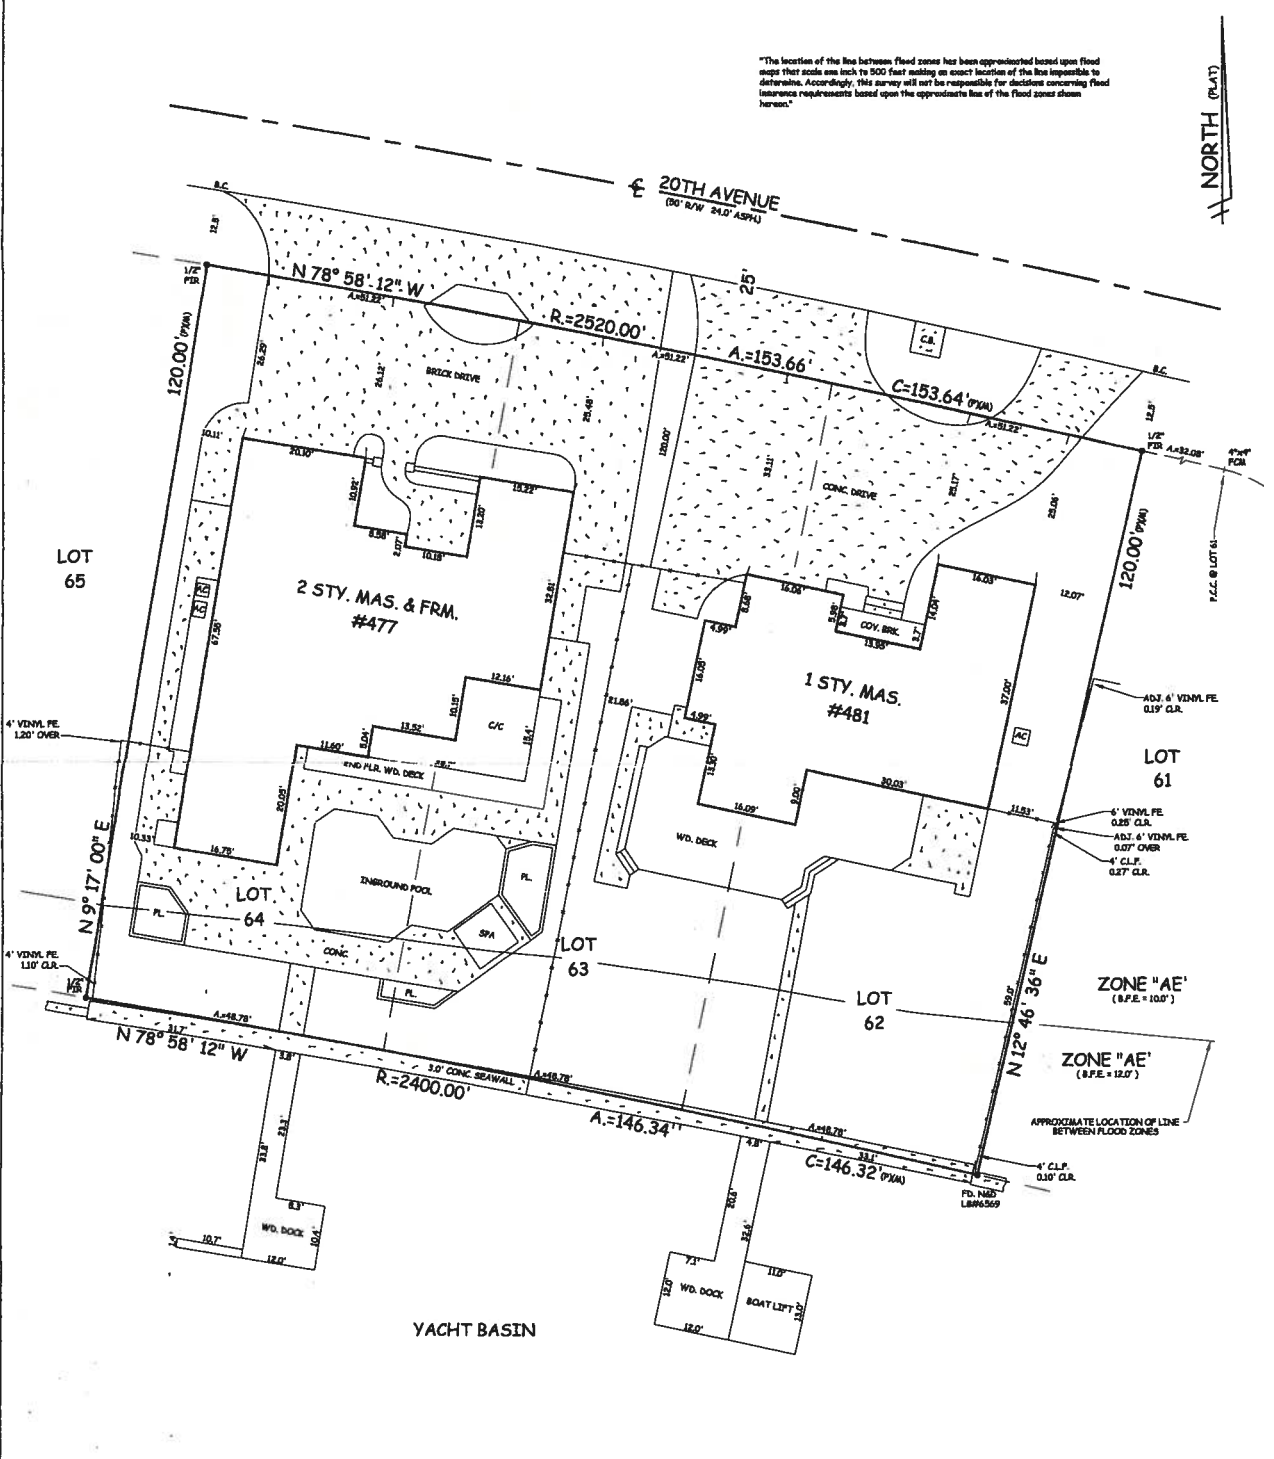

A BOUNDARY SURVEY OF: Lots 62, 63 and 64, FIFTEENTH ADDITION TO RE-REVISED MAP OF INDIAN BEACH, as recorded in Plat Book 31, Page 57 of the Public Records of Pinellas County, Florida.

According to the maps prepared by the U.S. Department of Homeland Security, this property appears to be located in Flood zone: AE Comm. Panel No.: 125117 0114 G Map Date: 9/03/03 Base Flood Elev: 10.0' - 12.0'

FOR THE EXCLUSIVE USE OF THE HEREON PARTY(IES), I HEREBY CERTIFY TO ITS ACCURACY EXCEPT SUCH BASEMENTS, IF ANY, THAT MAY BE LOCATED BELOW THE SURFACE OF THE LANDS, OR ON THE SURFACE OF THE LANDS AND NOT VISIBLE, AND THAT THE SURVEY REPRESENTED HEREON MEETS THE MINIMUM REQUIREMENTS OF CHAPTER 54-17, FLORIDA ADMINISTRATIVE CODE TO THE BEST OF MY KNOWLEDGE AND BELIEF. UNDERGROUND FOUNDATIONS AND/OR IMPROVEMENTS, IF ANY, ARE NOT SHOWN AND OTHER RESTRICTIONS AFFECTING THIS PROPERTY MAY EXIST IN THE PUBLIC RECORDS OF THIS COUNTY. SURVEY NOT VALID FOR MORE THAN ONE YEAR FROM DATE OF FIELD WORK AND NOT VALID UNLESS EMBOSSED WITH SURVEYOR'S SEAL. BEARINGS SHOWN ARE BASED ON PLAT, UNLESS OTHERWISE NOTED.

- | | | | | | | |
|--|--|---|---|--|--|---|
| <p>LEGEND:</p> <ul style="list-style-type: none"> F.I.P. - FOUND IRON PIPE F.C.M. - FOUND CONCRETE MONUMENT F.I.R. - FOUND IRON ROD S.I.R. - SET IRON ROD 1/2" LB #7410 P.C. - POINT OF CURVATURE P.R.C. - POINT OF REVERSE CURVATURE P.C.C. - POINT OF COMPOUND CURVATURE F.M. F.L. - FINISHED FLOOR ELEVATION P.R.M. - PERMANENT REFERENCE MONUMENT N.A.V.D. - NORTH AMERICAN VERTICAL DATUM OF 1988 | <ul style="list-style-type: none"> FD. - FOUND N.A.D. - NAIL AND DISK P.O.L. - POINT ON LINE P.C. - POINT OF CURVATURE P.T. - POINT OF TANGENCY P.I. - POINT OF INTERSECTION -X-X- - FENCE CL.F. - CHAIN LINK FENCE -#-#- - ADJACENT FENCE ADJ. - ADJACENT | <ul style="list-style-type: none"> R. - RADIUS A. - ARC C. - CHORD Δ - DELTA RAW - RIGHT OF WAY # - NUMBER MA. - MASONRY FRM. - FRAME GL. - GRATE INLET C.B. - CATCH BASIN F.H. - FIRE HYDRANT | <ul style="list-style-type: none"> M.S. - METAL SHED ALUM. - ALUMINUM WH. - WATER HEATER P.S. - PATIO STONE C.P. - CARPORT PL. - PLANTER B.C. - BACK OF CURB E.P. - EDGE OF PAVEMENT E.R. - EDGE OF ROAD E.O.W. - EDGE OF WATER T.O.B. - TOP OF BANK | <ul style="list-style-type: none"> WH. - WIND WALL CL. - CENTERLINE RAW - RIGHT OF WAY PL. - PLAT CD. - CALCULATION DE. - DEED ME. - MEASURED N. - NORTH S. - SOUTH E. - EAST W. - WEST | <ul style="list-style-type: none"> ESMT - EASEMENT M.H. - MANHOLE CONC. - CONCRETE CLR. - CLEAR COL. - COLUMN WD. - WOOD BLK. - BLOCK SN. - SEAWALL ASPH. - ASPHALT UTL. - UTILITY DR. - DRAINAGE | <ul style="list-style-type: none"> O.H. - OVERHANG DAR. - DRIVEWAY CONC. - COVERED CONCRETE C.P.S. - COVERED PATIO STONE CC. - COVERED CONCRETE AC. - AIR CONDITIONER S.P. - SCREENED PORCH P.P. - OVERHEAD POWER LINES T.T. - TELEPHONE LINES P.P. - POWER POLE L.P. - LIGHT POLE |
|--|--|---|---|--|--|---|

EDWARD D. MURPHY, REG. P.L.S. # 5335