

ELEVATION CERTIFICATE

Important: Read the instructions on pages 1-9.

OMB No. 1660-0008
 Expiration Date: July 31, 2015

SECTION A - PROPERTY INFORMATION

FOR INSURANCE COMPANY USE

A1. Building Owner's Name Kellie Johnson & James Johnson

Policy Number:

A2. Building Street Address (including Apt., Unit, Suite, and/or Bldg. No.) or P.O. Route and Box No.
487 Harbor Drive S.

Company Name: RECEIVED

City Indian Rocks Beach State FL ZIP Code 33785

A3. Property Description (Lot and Block Numbers, Tax Parcel Number, Legal Description, etc.)
Lot 15 & rip rts, Indian Beach Re-revised 23rd Addition

A4. Building Use (e.g., Residential, Non-Residential, Addition, Accessory, etc.) Residential

A5. Latitude/Longitude: Lat. 27d 54' 15.52" N. Long. 82d 50' 14.23" W.

Horizontal Datum: NAD 1927 NAD 1983

A6. Attach at least 2 photographs of the building if the Certificate is being used to obtain flood insurance.

A7. Building Diagram Number 1A

A8. For a building with a crawlspace or enclosure(s):

- a) Square footage of crawlspace or enclosure(s) NA sq ft
- b) Number of permanent flood openings in the crawlspace or enclosure(s) within 1.0 foot above adjacent grade NA
- c) Total net area of flood openings in A8.b NA sq in
- d) Engineered flood openings? Yes No

A9. For a building with an attached garage:

- a) Square footage of attached garage 479.3 sq ft
- b) Number of permanent flood openings in the attached garage within 1.0 foot above adjacent grade 3
- c) Total net area of flood openings in A9.b 600.0 sq in
- d) Engineered flood openings? Yes No

SECTION B - FLOOD INSURANCE RATE MAP (FIRM) INFORMATION

B1. NFIP Community Name & Community Number
Indian Rocks Beach 125103

B2. County Name
Pinellas

B3. State
Florida

B4. Map/Panel Number
12103C 0114

B5. Suffix
G

B6. FIRM Index Date
9/3/03

B7. FIRM Panel Effective/Revised Date
9/3/03

B8. Flood Zone(s)
AE

B9. Base Flood Elevation(s) (Zone AO, use base flood depth)
10.0'

B10. Indicate the source of the Base Flood Elevation (BFE) data or base flood depth entered in Item B9.

- FIS Profile FIRM Community Determined Other/Source: _____

B11. Indicate elevation datum used for BFE in Item B9: NGVD 1929 NAVD 1988 Other/Source: _____

B12. Is the building located in a Coastal Barrier Resources System (CBRS) area or Otherwise Protected Area (OPA)? Yes No
 Designation Date: _____
 CBRS OPA

SECTION C - BUILDING ELEVATION INFORMATION (SURVEY REQUIRED)

C1. Building elevations are based on: Construction Drawings* Building Under Construction* Finished Construction
 *A new Elevation Certificate will be required when construction of the building is complete.

C2. Elevations - Zones A1-A30, AE, AH, A (with BFE), VE, V1-V30, V (with BFE), AR, AR/A, AR/AE, AR/A1-A30, AR/AH, AR/AO. Complete Items C2.a-h below according to the building diagram specified in Item A7. In Puerto Rico only, enter meters.

Benchmark Utilized: Hall B Vertical Datum: NAVD 1988

Indicate elevation datum used for the elevations in items a) through h) below. NGVD 1929 NAVD 1988 Other/Source: _____
 Datum used for building elevations must be the same as that used for the BFE.

- Check the measurement used.
- a) Top of bottom floor (including basement, crawlspace, or enclosure floor) 7.2 feet meters
 - b) Top of the next higher floor N.A feet meters
 - c) Bottom of the lowest horizontal structural member (V Zones only) N.A feet meters
 - d) Attached garage (top of slab) 6.8 feet meters
 - e) Lowest elevation of machinery or equipment servicing the building (Describe type of equipment and location in Comments) 8.6 feet meters
 - f) Lowest adjacent (finished) grade next to building (LAG) 6.6 feet meters
 - g) Highest adjacent (finished) grade next to building (HAG) 6.7 feet meters
 - h) Lowest adjacent grade at lowest elevation of deck or stairs, including structural support N.A feet meters

SECTION D - SURVEYOR, ENGINEER, OR ARCHITECT CERTIFICATION

This certification is to be signed and sealed by a land surveyor, engineer, or architect authorized by law to certify elevation information. I certify that the information on this Certificate represents my best efforts to interpret the data available. I understand that any false statement may be punishable by fine or imprisonment under 18 U.S. Code, Section 1001.

- Check here if comments are provided on back of form. Were latitude and longitude in Section A provided by a licensed land surveyor? Yes No
 Check here if attachments.

Certifier's Name Edward D. Murphy

License Number 5333

Title Prof. Land Surveyor

Company Name Murphy's Land Surveying, Inc.

Address 5760 11th Avenue N.

City St. Petersburg

State FL ZIP Code 33710

Signature [Signature] Date 9/24/15

Telephone 727/347-8740

[Signature]
 # 5333
 9-24-15

IMPORTANT: In these spaces, copy the corresponding information from Section A.		FOR INSURANCE COMPANY USE	
Building Street Address (including Apt., Unit, Suite, and/or Bldg. No.) or P.O. Route and Box No. 487 Harbor Drive S.		Policy Number:	
City Indian Rocks Beach	State FL	ZIP Code 33785	Company NAIC Number:

SECTION D – SURVEYOR, ENGINEER, OR ARCHITECT CERTIFICATION (CONTINUED)

Copy both sides of this Elevation Certificate for (1) community official, (2) insurance agent/company, and (3) building owner.

Comments C2e = A/C

Signature *Edward D. [Signature]* Date 9/24/15

SECTION E – BUILDING ELEVATION INFORMATION (SURVEY NOT REQUIRED) FOR ZONE AO AND ZONE A (WITHOUT BFE)

For Zones AO and A (without BFE), complete Items E1–E5. If the Certificate is intended to support a LOMA or LOMR-F request, complete Sections A, B, and C. For Items E1–E4, use natural grade, if available. Check the measurement used. In Puerto Rico only, enter meters.

- E1. Provide elevation information for the following and check the appropriate boxes to show whether the elevation is above or below the highest adjacent grade (HAG) and the lowest adjacent grade (LAG).
 - a) Top of bottom floor (including basement, crawlspace, or enclosure) is _____ feet meters above or below the HAG.
 - b) Top of bottom floor (including basement, crawlspace, or enclosure) is _____ feet meters above or below the LAG.
- E2. For Building Diagrams 6–9 with permanent flood openings provided in Section A Items 8 and/or 9 (see pages 8–9 of Instructions), the next higher floor (elevation C2.b in the diagrams) of the building is _____ feet meters above or below the HAG.
- E3. Attached garage (top of slab) is _____ feet meters above or below the HAG.
- E4. Top of platform of machinery and/or equipment servicing the building is _____ feet meters above or below the HAG.
- E5. Zone AO only: If no flood depth number is available, is the top of the bottom floor elevated in accordance with the community's floodplain management ordinance? Yes No Unknown. The local official must certify this information in Section G.

SECTION F – PROPERTY OWNER (OR OWNER'S REPRESENTATIVE) CERTIFICATION

The property owner or owner's authorized representative who completes Sections A, B, and E for Zone A (without a FEMA-issued or community-issued BFE) or Zone AO must sign here. The statements in Sections A, B, and E are correct to the best of my knowledge.

Property Owner's or Owner's Authorized Representative's Name _____

Address _____ City _____ State _____ ZIP Code _____

Signature _____ Date _____ Telephone _____

Comments _____

Check here if attachments.

SECTION G – COMMUNITY INFORMATION (OPTIONAL)

The local official who is authorized by law or ordinance to administer the community's floodplain management ordinance can complete Sections A, B, C (or E), and G of this Elevation Certificate. Complete the applicable item(s) and sign below. Check the measurement used in Items G8–G10. In Puerto Rico only, enter meters.

- G1. The information in Section C was taken from other documentation that has been signed and sealed by a licensed surveyor, engineer, or architect who is authorized by law to certify elevation information. (Indicate the source and date of the elevation data in the Comments area below.)
- G2. A community official completed Section E for a building located in Zone A (without a FEMA-issued or community-issued BFE) or Zone AO.
- G3. The following information (Items G4–G10) is provided for community floodplain management purposes.

G4. Permit Number _____	G5. Date Permit Issued _____	G6. Date Certificate Of Compliance/Occupancy Issued _____
-------------------------	------------------------------	---

- 37. This permit has been issued for: New Construction Substantial Improvement
- 38. Elevation of as-built lowest floor (including basement) of the building: _____ feet meters Datum _____
- 39. BFE or (in Zone AO) depth of flooding at the building site: _____ feet meters Datum _____
- 310. Community's design flood elevation: _____ feet meters Datum _____

Local Official's Name _____ Title _____

Community Name _____ Telephone _____

Signature _____ Date _____

Comments _____

Check here if attachments.

Building Photographs

See Instructions for Item A6.

IMPORTANT: In these spaces, copy the corresponding information from Section A.

FOR INSURANCE COMPANY USE

Building Street Address (including Apt., Unit, Suite, and/or Bldg. No.) or P.O. Route and Box No.
487 Harbor Drive S.

Policy Number:

City Indian Rocks Beach

State FL ZIP Code 33785

Company NAIC Number:

If using the Elevation Certificate to obtain NFIP flood insurance, affix at least 2 building photographs below according to the instructions for Item A6. Identify all photographs with date taken; "Front View" and "Rear View"; and, if required, "Right Side View" and "Left Side View." When applicable, photographs must show the foundation with representative examples of the flood openings or vents, as indicated in Section A8. If submitting more photographs than will fit on this page, use the Continuation Page.

DATE: 9/21/15



FRONT VIEW:




REAR VIEW:

JOP NO.: 151513		MURPHY'S LAND SURVEYING, INC. PROFESSIONAL LAND SURVEYORS 5760 11TH AVENUE NORTH ST. PETERSBURG, FLORIDA 33710 WWW.MURPHYSLANDSURVEYING.COM	L.B. #7410
DRAWN BY: MRB	CHECKED BY: EDM		PH. (727) 347-8740
DATE OF FIELD WORK: 9/21/15			FAX (727) 344-4640

CERTIFIED TO: Kellie Johnson and James Johnson

SCALE: 1" = 20' Survey not valid for more than one (1) year from date of field work. SEC. 06 TWP. 30 S. RGE. 15 E.

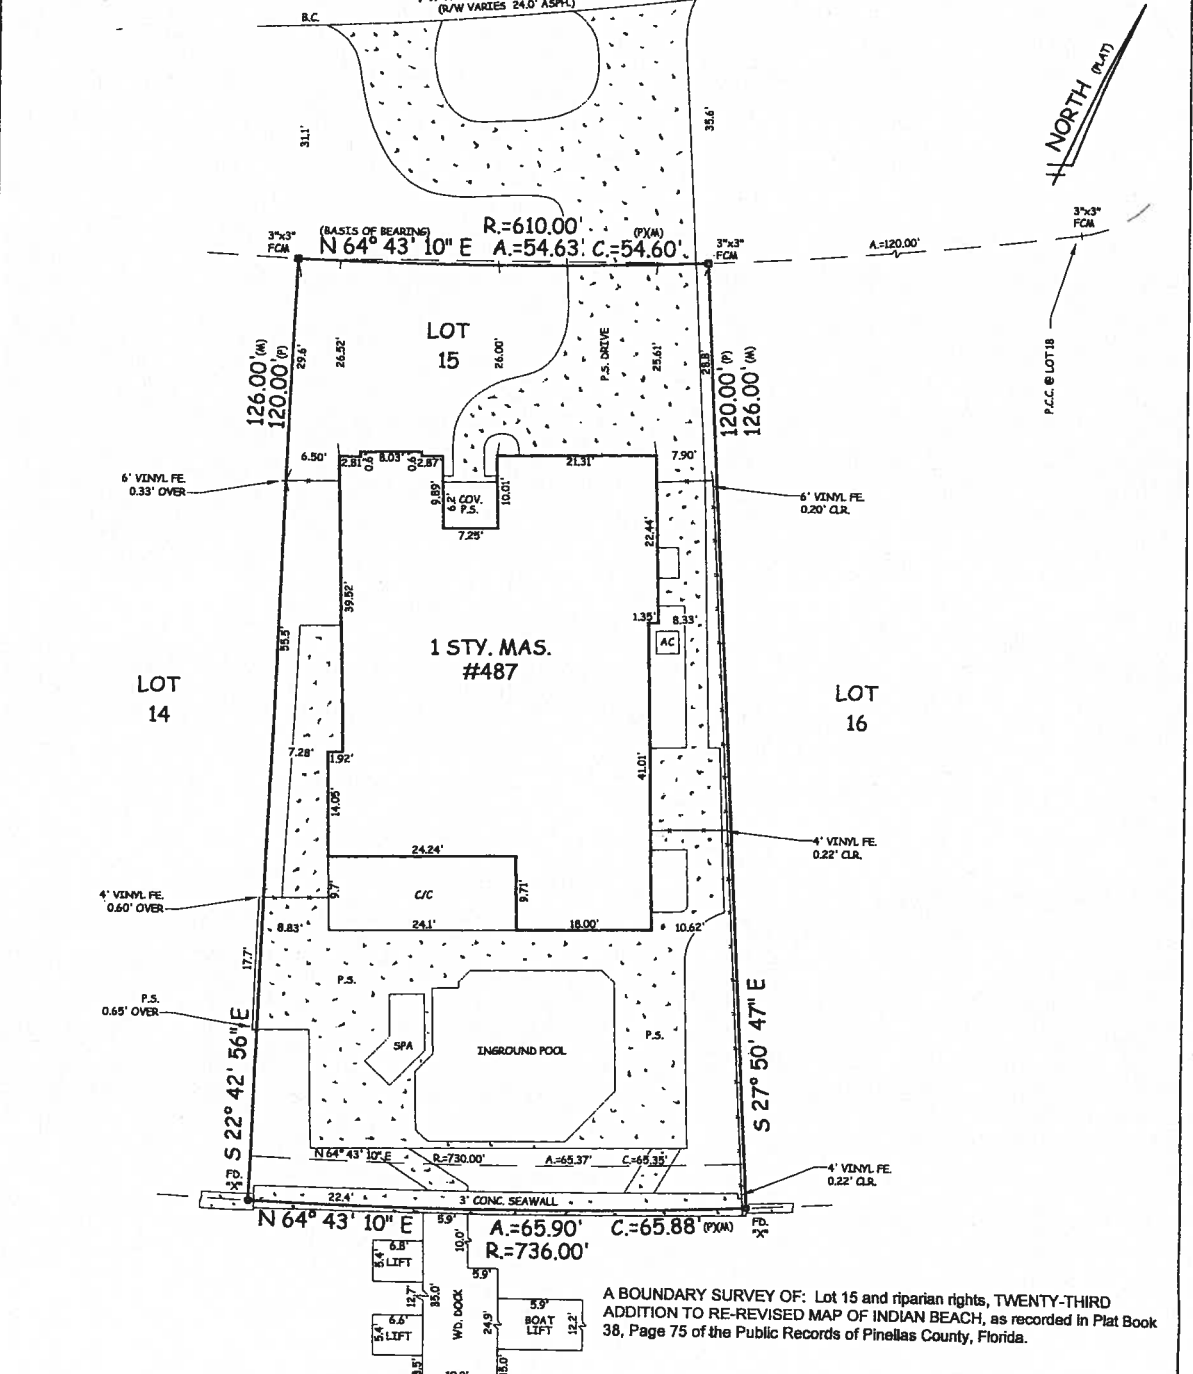

According to the maps prepared by the U.S. Department of Homeland Security, this property appears to be located in Flood zone: AE Comm. Panel No.: 125117 0114 G Map Date: 9/03/03 Base Flood Elev: 10.0'

FOR THE EXCLUSIVE USE OF THE HEREON PARTY(IES), I HEREBY CERTIFY TO ITS ACCURACY (EXCEPT SUCH EASEMENTS, IF ANY, THAT MAY BE LOCATED BELOW THE SURFACE OF THE LANDS, OR ON THE SURFACE OF THE LANDS AND NOT VISIBLE), AND THAT THE SURVEY REPRESENTED HEREON MEETS THE MINIMUM REQUIREMENTS OF CHAPTER 54-17, FLORIDA ADMINISTRATIVE CODE TO THE BEST OF MY KNOWLEDGE AND BELIEF. UNDERGROUND FOUNDATIONS AND/OR IMPROVEMENTS, IF ANY, ARE NOT SHOWN AND OTHER RESTRICTIONS AFFECTING THIS PROPERTY MAY EXIST IN THE PUBLIC RECORDS OF THIS COUNTY. (THIS SURVEY HAS BEEN DONE WITHOUT THE BENEFIT OF REVIEWING A CURRENT TITLE SEARCH). SURVEY NOT VALID FOR MORE THAN ONE YEAR FROM DATE OF FIELD WORK AND NOT VALID UNLESS EMBOSSED WITH SURVEYORS SEAL. BEARINGS SHOWN ARE BASED ON PLAT, UNLESS OTHERWISE NOTED.

Edward D. Murphy
EDWARD D. MURPHY, REG. P.L.S. # 5338

LEGEND:	FD - FOUND	R - RADIUS	M/S - METAL SHED	WWW - WING WALL	ESMT. - EASEMENT
F.I.P. - FOUND IRON PIPE	N.A.D. - NAIL AND DISK	A - ARC	ALUM. - ALUMINUM	CL - CENTERLINE	O.H. - OVERHANG
F.C.M. - FOUND CONCRETE MONUMENT	P.O.L. - POINT ON LINE	C - CHORD	WH. - WATER HEATER	CL - CENTERLINE	GAR. - GARAGE
F.I.R. - FOUND IRON ROD	P.C. - POINT OF CURVATURE	Δ - DELTA	P.S. - PATIO STONE	CL - CLEAR	COV. - COVERED WOOD
S.I.R. - SET IRON ROD 1/2" LB #7410	P.T. - POINT OF TANGENCY	RAW - RIGHT OF WAY	C.P. - CARPORT	CP.S. - COVERED CONCRETE	CP.S. - COVERED PATIO STONE
P.C. - POINT OF COMPOUND CURVATURE	P.I. - POINT OF INTERSECTION	# - NUMBER	PL. - PLANTER	AC. - COVERED CONCRETE	AC. - AIRCONDITIONER
FIN. FLR. - FINISHED FLOOR ELEVATION	-X-X- - FENCE	MAB. - MASONRY	B.C. - BACK OF CURB	WD. - WOOD	BLK. - BLOCK
P.R.M. - PERMANENT REFERENCE MONUMENT	FE. - FENCE	FRM. - FRAME	E.P. - EDGE OF CURB	SW - SEAWALL	SP. - SCREENED PORCH
N.A.V.D. - NORTH AMERICAN VERTICAL DATUM OF 1988	C.L.F. - CHAIN LINK FENCE	G.I. - GRATE INLET	E.R. - EDGE OF PAVEMENT	ASPH. - ASPHALT	P-P - OVERHEAD POWER LINES
	A.J. - ADJACENT FENCE	C.B. - CATCH BASIN	E.O.W. - EDGE OF WATER	UTIL. - UTILITY	T-T - OVERHEAD TELEPHONE LINES
	ADJ. - ADJACENT	F.H. - FIRE HYDRANT	T.O.B. - TOP OF BANK	DR. - DRAINAGE	P.P. - POWER POLE
					LP. - LIGHT POLE